

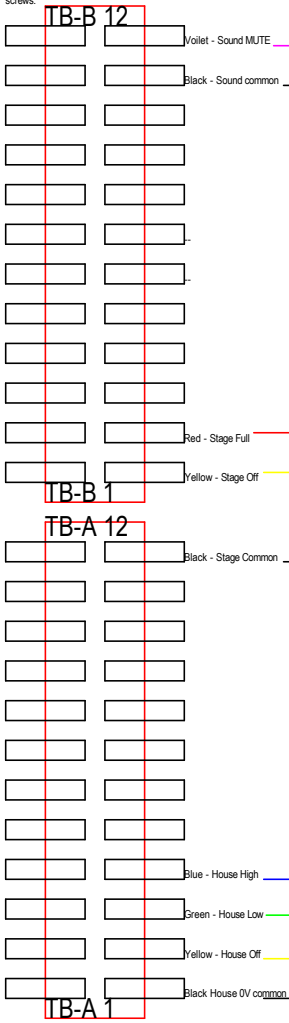
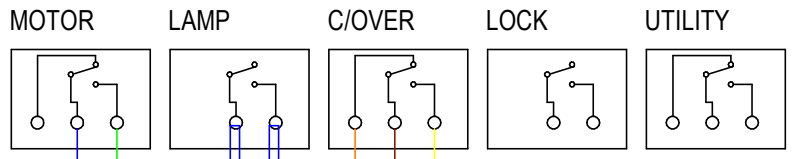


TB mounted on relay cover strip, tapped and screwed to the left of the mounting screws.

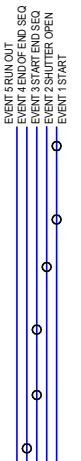

**CURZON SOHO
AS BUILT**

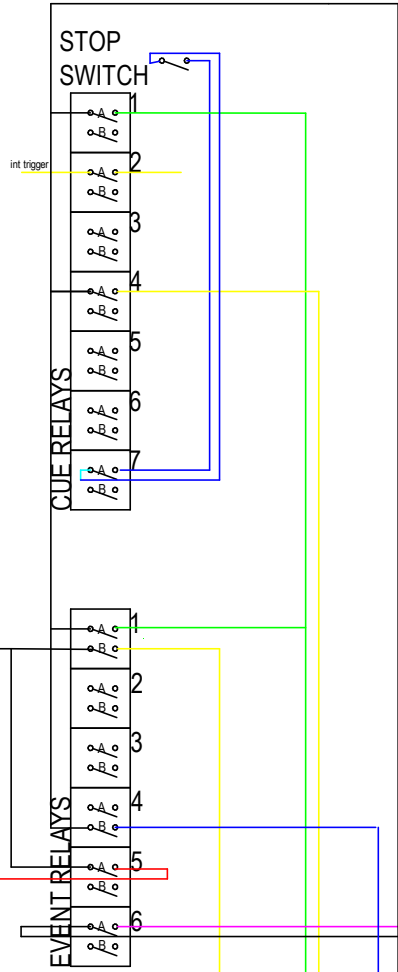

TO RECTIFIER

MULTICORE TO PROJECTOR

- Blue Motor
- Green Motor
- Orange C/O Close
- Projector Common LV
- LV Close
- turret go (only if turret)